


LEGEND

- SITE ACCESS
- LIMITS OF DISTURBANCE
- EXISTING 2 FOOT CONTOUR
- EXISTING 10 FOOT CONTOUR
- ABANDON SEWER PIPE
- SEWER PIPE

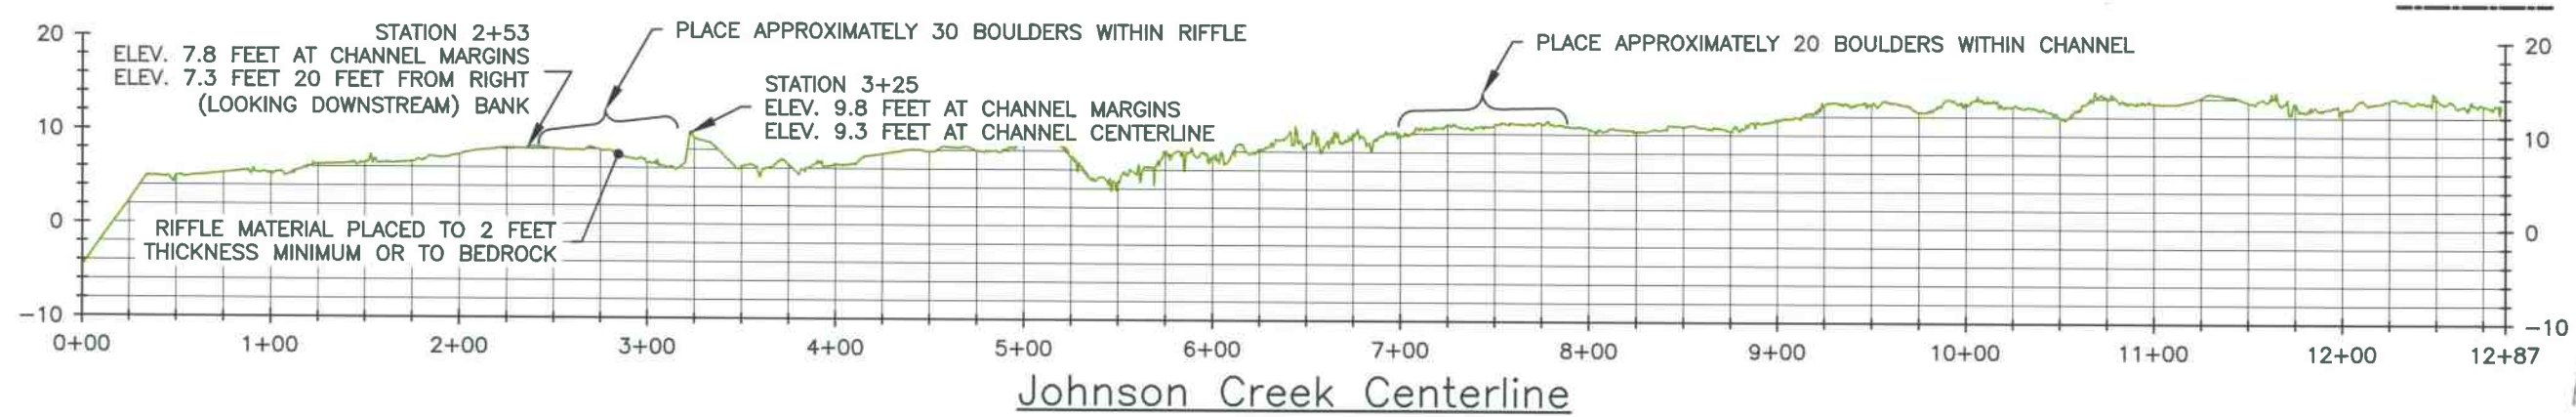

PROFILE

2
4

PROFILE

1" = 100'



Expires: 12-31-2012

REP,STM	BN	BN
DRAWN	DESIGNED	CHECKED
BN	07-22-2011	
APPROVED	DATE	PROJECT

JOHNSON CREEK WATERSHED COUNCIL
JOHNSON CREEK - WILLAMETTE RIVER
CONFLUENCE HABITAT ENHANCEMENT



Aquatic Contracting, LLC
8316 N Lombard, #374
Portland, OR 97203
TEL 503.490.2933
info@aquatic-con.com



1020 Wisco Street, Suite 1
Hood River, OR 97031
541.386.9003
www.interfluve.com

AS BUILT -- PLAN AND PROFILE

SHEET
5
OF 8